


The PBR controller is assembled in a polycarbonate enclosure with a 3D printed subframe to mount the components.

Notes:

- Cable Access is in the lower right corner, Two $\frac{1}{4}$ push connectors for CD2, A BNC bulkhead connector for pH, two cable glands for temperature and cooling vavle.
- The power cable emerges through a gable gland at the lower left side of the enclosure.
- All field connections are to be done on the upper side of the terminal block while local connections are done on the lower side of the terminal block.

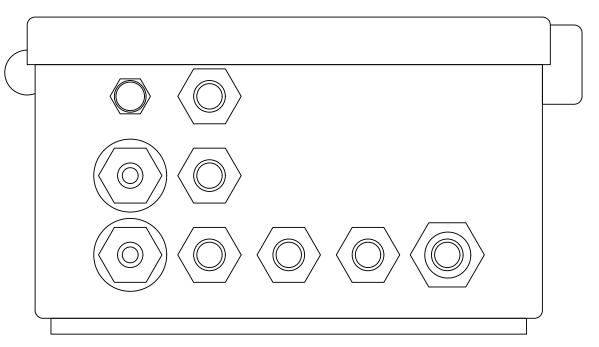


SymbCtrl F	Drawn By And	Арргоvед	
Symbrosia			
124	024		

025-030 Layout 25Sep2024

drew Cooper

Da te	19Jan2024	4202daS92	-	_	
Note	Initial Release	As-built	1	-	
Kev.	-	_	_	-	
age					

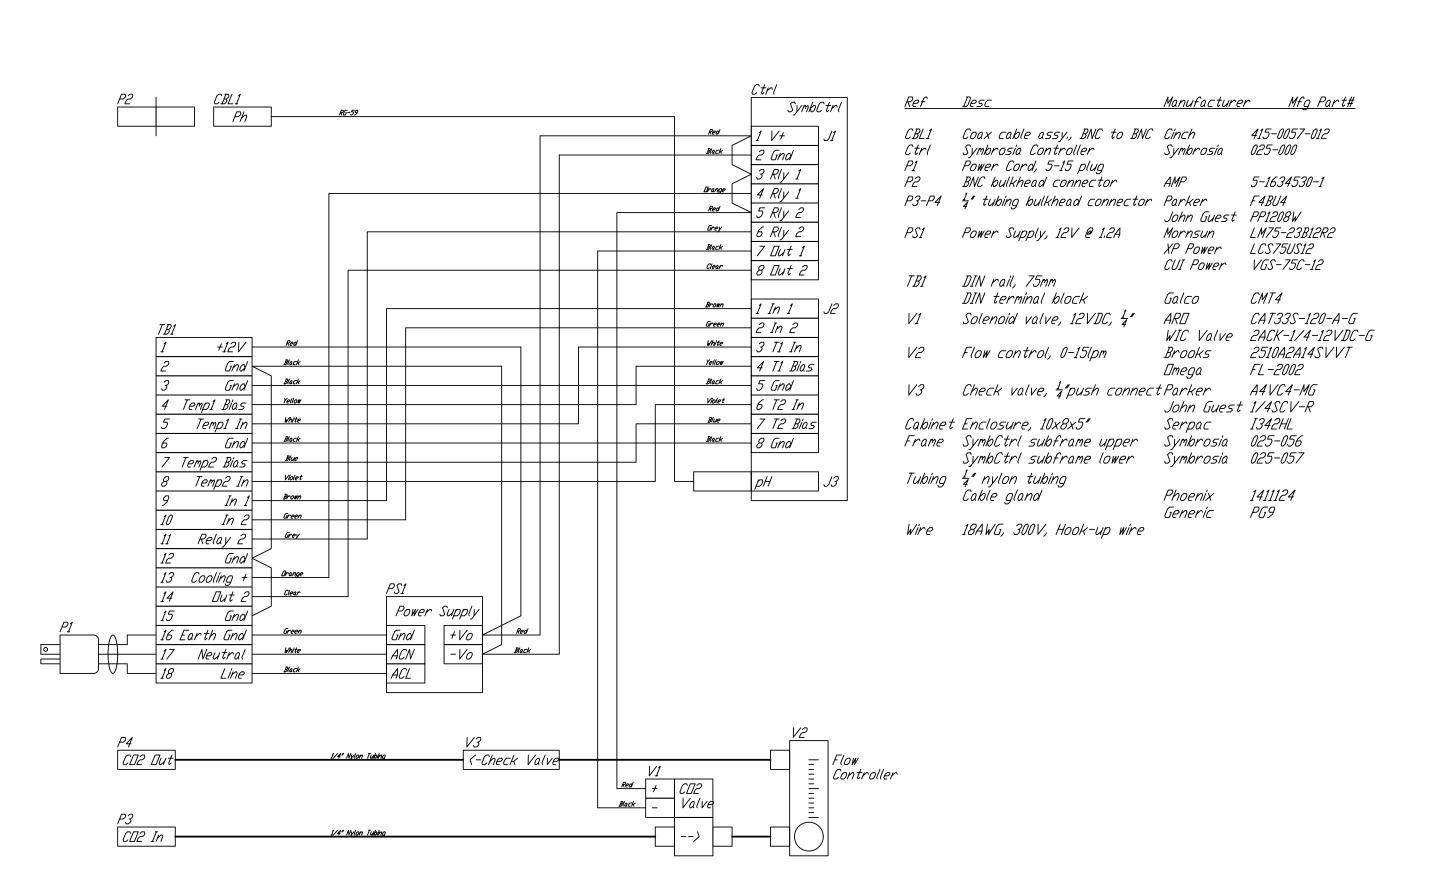

Drawn By Andrew Cooper SymbCtrl Symbrosia

> 26Sep2024 11Mar2024 Da te

> > As-built

Release

Note Inital

Page 2

Page 2

025-030 Schema tic 25Sep2024

Control

PBR